






This material and the information herein is the property of Fuji Electric Systems Co., Ltd.. They shall be neither reproduced, copied, lent, or disclosed in any way whatsoever for the use of any third party, nor used for the manufacturing process without the express written consent of Fuji Electric Systems Co., Ltd..

Owner	 MAGMA NUSANTARA LTD		
Project	WAYANG WINDU UNIT2 GEOTHERMAL POWER PROJECT		
Contract No.	Contractor <div style="display: flex; align-items: center; justify-content: center;"> <div style="border: 1px solid black; padding: 2px; margin-right: 5px;"> 71510012-OS </div> <div style="text-align: center;">  </div> <div style="margin-left: 10px;"> Sumitomo Corporation </div> </div>		
MNL Drawing No.	<table border="1" style="width: 100%; border-collapse: collapse;"> <tr> <td style="text-align: center; padding: 10px;">WW2 - ME - LU - 5350</td> <td style="text-align: center; padding: 10px; width: 10%;">0</td> </tr> </table>	WW2 - ME - LU - 5350	0
WW2 - ME - LU - 5350	0		
Dwg. Status	<div style="border: 2px solid black; padding: 10px; font-size: 24px; font-weight: bold;">AS BUILT</div>		

REVISIONS	B) ISSUED FOR AS BUILT. Feb-13-2009 Yokoyama, Takeyama		DWG. CODE	CONTROL NO.: WW2-ME-LU-5350				
	A) ISSUED FOR CONSTRUCTION. May-26-2008 Yokoyama, Takeyama		TITLE	K1B10159G1 OUTLINE DRAWING OF EMERGENCY OIL PUMP				
DRAWN	Yokoyama	APPROVED	SCALE	<div style="font-size: 36px; font-weight: bold;">ST7C5442</div> <div style="font-size: 24px;">1/10</div>				
CHECKED	Takeyama		DRAWING NO.					
DATE	Feb. - 5-2008 <i>f. Idori</i>							
Fuji Electric Systems Co., Ltd.			REF.	<table border="1" style="border-collapse: collapse;"> <tr> <td style="width: 20px; height: 20px;"></td> <td style="width: 20px; height: 20px; text-align: center;">A</td> </tr> <tr> <td style="width: 20px; height: 20px;"></td> <td style="width: 20px; height: 20px; text-align: center;">B</td> </tr> </table>		A		B
	A							
	B							

KANSUI PUMP CO., LTD

DWG. No. H4007071
WORK No 200712-2

PUMP DATE SHEET

MESSRS	FUJI ELECTRIC SYSTEMS CO., LTD		
USER	WAYANG WINDU	ITEM No	P-203
SERVICE	EMERGENCY OIL PUMP	NO REQUIRED :	1

OPERATING CONDITIONS

LIQUID :	TURBINE OIL ISO VG32	CAPACITY :	25	m ³ /h
		SUCTION HEAD :	—	MPaG
LIQUID TEMP	30 ~ 70 °C	DISCHARGE PRESSURE	—	MPaG
SPECIFIC GRAVITY :	0.852~0.825 kg/	DIFFERENTIAL PRESSURE	1.9	bar
VAPOR PRESSURE :	— KPaA	DIFFERENTIAL HEAD :	1.9	bar
VISCOSITY	51.5 × 10 ⁻⁶ ~ 11.3 × 10 ⁻⁶ m ² -S	NPSH AVAILABLE :	—	m
pH :	—	INSTALLATION	INDOOR	

PERFORMANCE

SPEED	1750 min ⁻¹	CASING DESIGN PRESS :	0.294	MPaG
Ns (m ³ /m min ⁻¹) :	—	CASING DESIGN TEMP :	77	°C
NPSH REQUIRED :	— m	JACKET DESIGN PRESS	—	MPaG
EFFICIENCY :	38 %	COOLING WATER REQ' D :	—	MPaG
BRAKE HORSE POWER	3.5 kW	FLUSHING LIQUID REQ' D	—	MPaG
		HEATING STEAM REQ' D	—	MPaG
MIN CONTINUOUS FLOW	—			
METHOD OF PRIMING :	—			

CONSTRUCTIONS

TYPE							VERTICAL TYPE SINGLE SUCTION VOLUTE PUMP						
MODEL NO			65 VSC-1 #2640				NO OF STAGE :			1			
CASING			SINGLE VOLUTE				SPLIT			RADIALLY			
IMPELLER :			CLOSE TYPE				MOUNTING :			TANK TOP MOUNT			
CONNECTION		SIZE	RATING		FACING	POSITION	VENT						
SUCTION FLANGE		—	—		BELL MOUTH	BOTTOM	DRAIN : —						
DISCHARGE FLANGE		65A	JIS 10k		F·F	HORIZONTAL	GAUGE		SW 1/2				
METHOD OF SHAFT SEAL							SEAL LESS						
MECHANICAL SEAL		MODEL NO	SIZE	MATERIAL	FLUSHING	COOLING WATER							
GLAND PACKING :		—	—	—	—	—	MPa	— /min					
BEARING		BALL	PLANE	LUBRICANT	CAPACITY	SYSTEM	COOLING WATER						
RADIAL		—	CARBON	ISO VG32	—	OIL BATH	—	MPa	— /min				
THRUST		#6309	—	ISO VG32	—	FLOOD	—	MPa	— /min				
POWER TRANSMISSION							FLEXIBLE COUPLING						
ROTATION VIEWED FROM DRIVER							CW						
MATERIAL		CASING :	FC250	IMPELLER	SCS13	SHAFT	SUS304						
MOUTHPIECE		SUS304	SLEEVE :	—	COUPLING	FC200	BASEPLATE SS400						
CASING STUJ		SS400	GASKET	NBR	STRAINER	SUS304							

DRIVER

OUT PUT :	5.5 kW	SPEED :	1750 min ⁻¹	MFR	YASKAWA	MODEL NO	GFEVF #180L
ELEC POWER	— Hz	230 V DC PHASE	INSULATION	F / B	POLES :	4	

TEST & INSPECTION

PUMPING PERFORMANCE TEST		JIS-B8301	
HYDROSTATIC TEST :	0.45	MPaG	
PNEUMATIC TEST	—	MPaG	

MISCELLANEOUS

MASS (APPROX)							
PUMP :	250 kg						
BASE :	90 kg						
DRIVER	245 kg						
TOTAL	585 kg	REV NO	DESCRIPTION	DATE	DRA	CHE	APP

APPROVED 大野 CHECKED 吉良 DRAWN 橋本 DATE JULY 11 2007

ST7C5442B 2/10

PERFORMANCE CURVE

KANSUI PUMP CO., LTD.
 KOBE JAPAN


WANG WINDU

EMERGENCY OIL PUMP

APPROVED BY 大野
 CHECKED BY 大野
 DRAWN BY 大野
 DATE JULY.11.2007

WORK NO. 200712-2

PUMP NO	BORE	MODEL & NO.	Q	HT	SPEED	MOTOR
P-203	65	VSC #2640	25 m ³ /h	1.9 bar	1750 min ⁻¹	5.5 kW 4 P 230 V DC



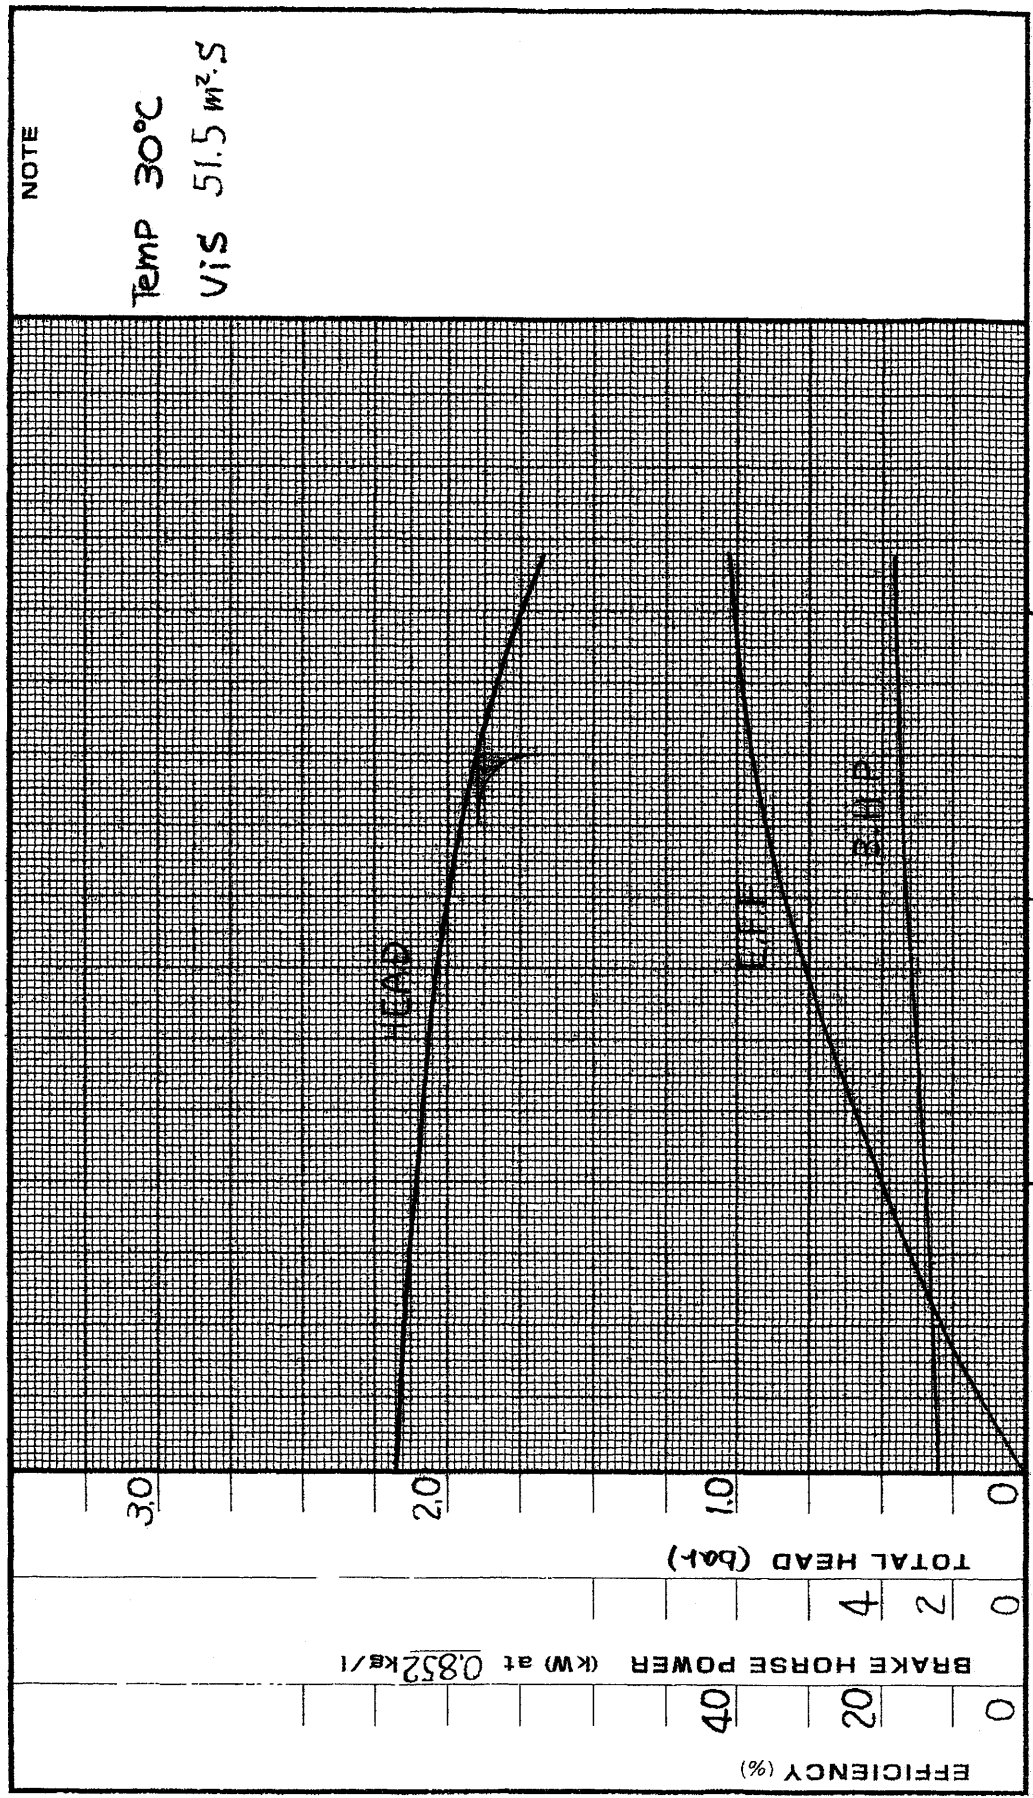


H4007072

CAPACITY m³/h

DRAWING No H4007072


ST7C5442B 3/10

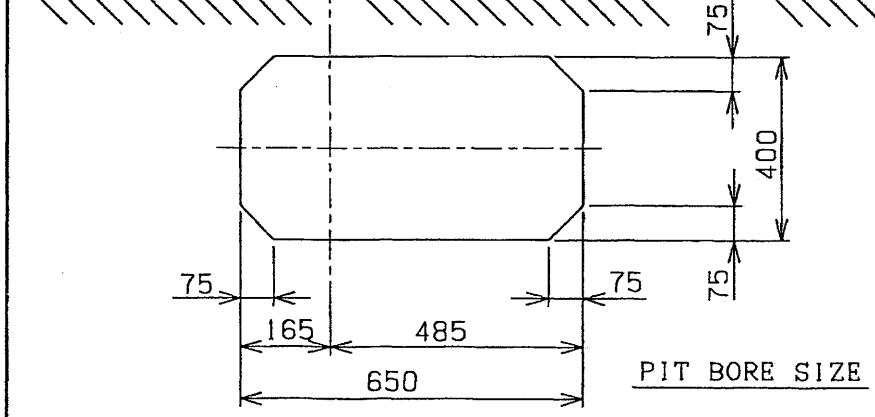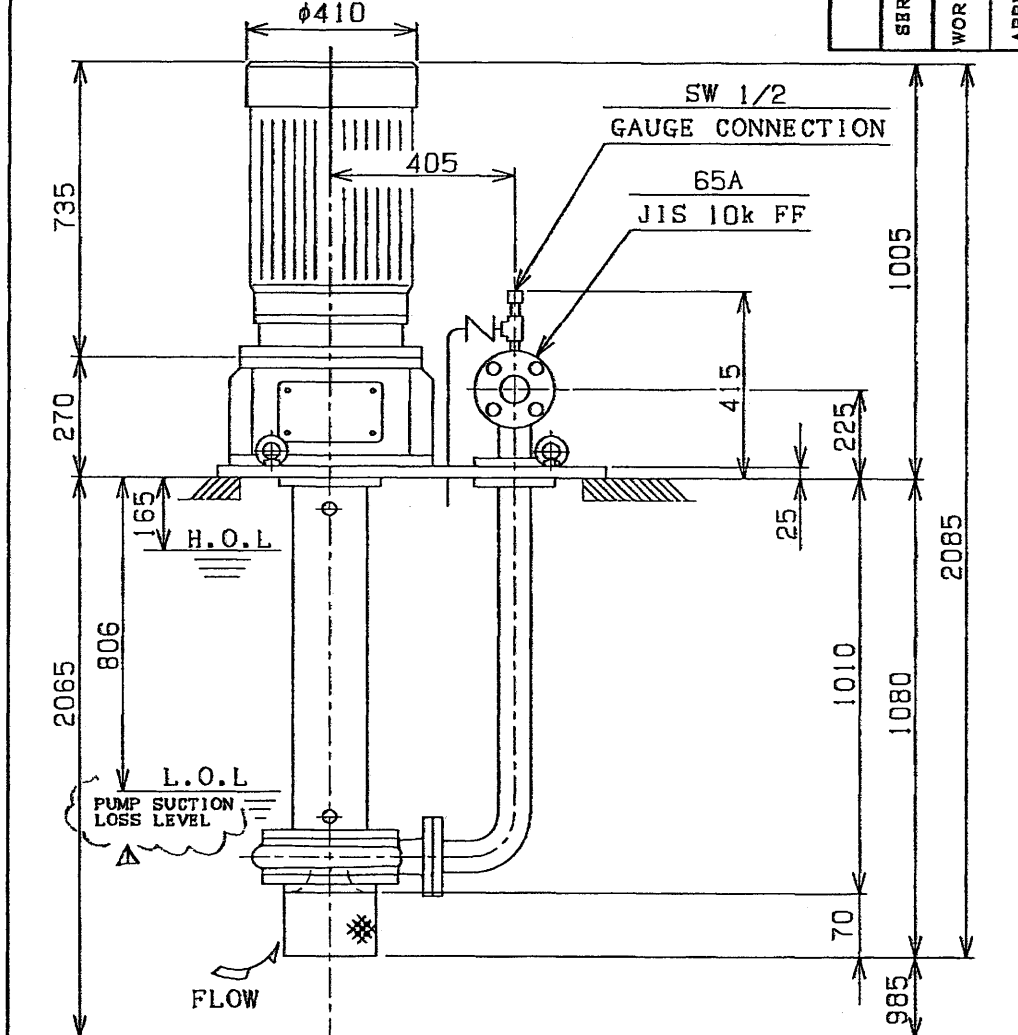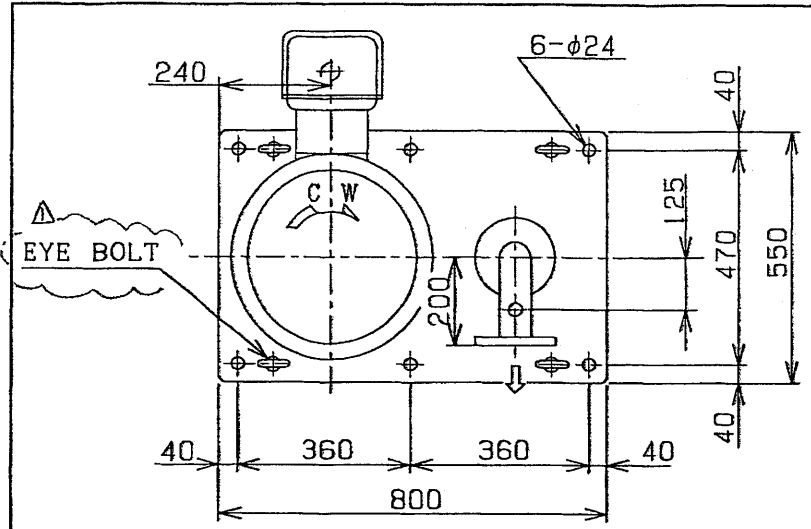

OUTLINE DRAWING			
SERVICE	EMERGENCY OIL PUMP		
WORK No.	200712-2	ITEM No.	P-203
APPROVED	矢野	MODEL	VSC
CHECKED	吉良	SCALE	NONE
DRAWN	橋本	DATE	JULY.11.2007
DWG NO.	G4007073		
KANSUI PUMP CO., LTD.			

REV	DATE	DESCRIPTION	DRA.	CHK.	APP.
1	Oct. 26 2007	Eye bolts are added.	橋本	吉良	矢野

K3007379

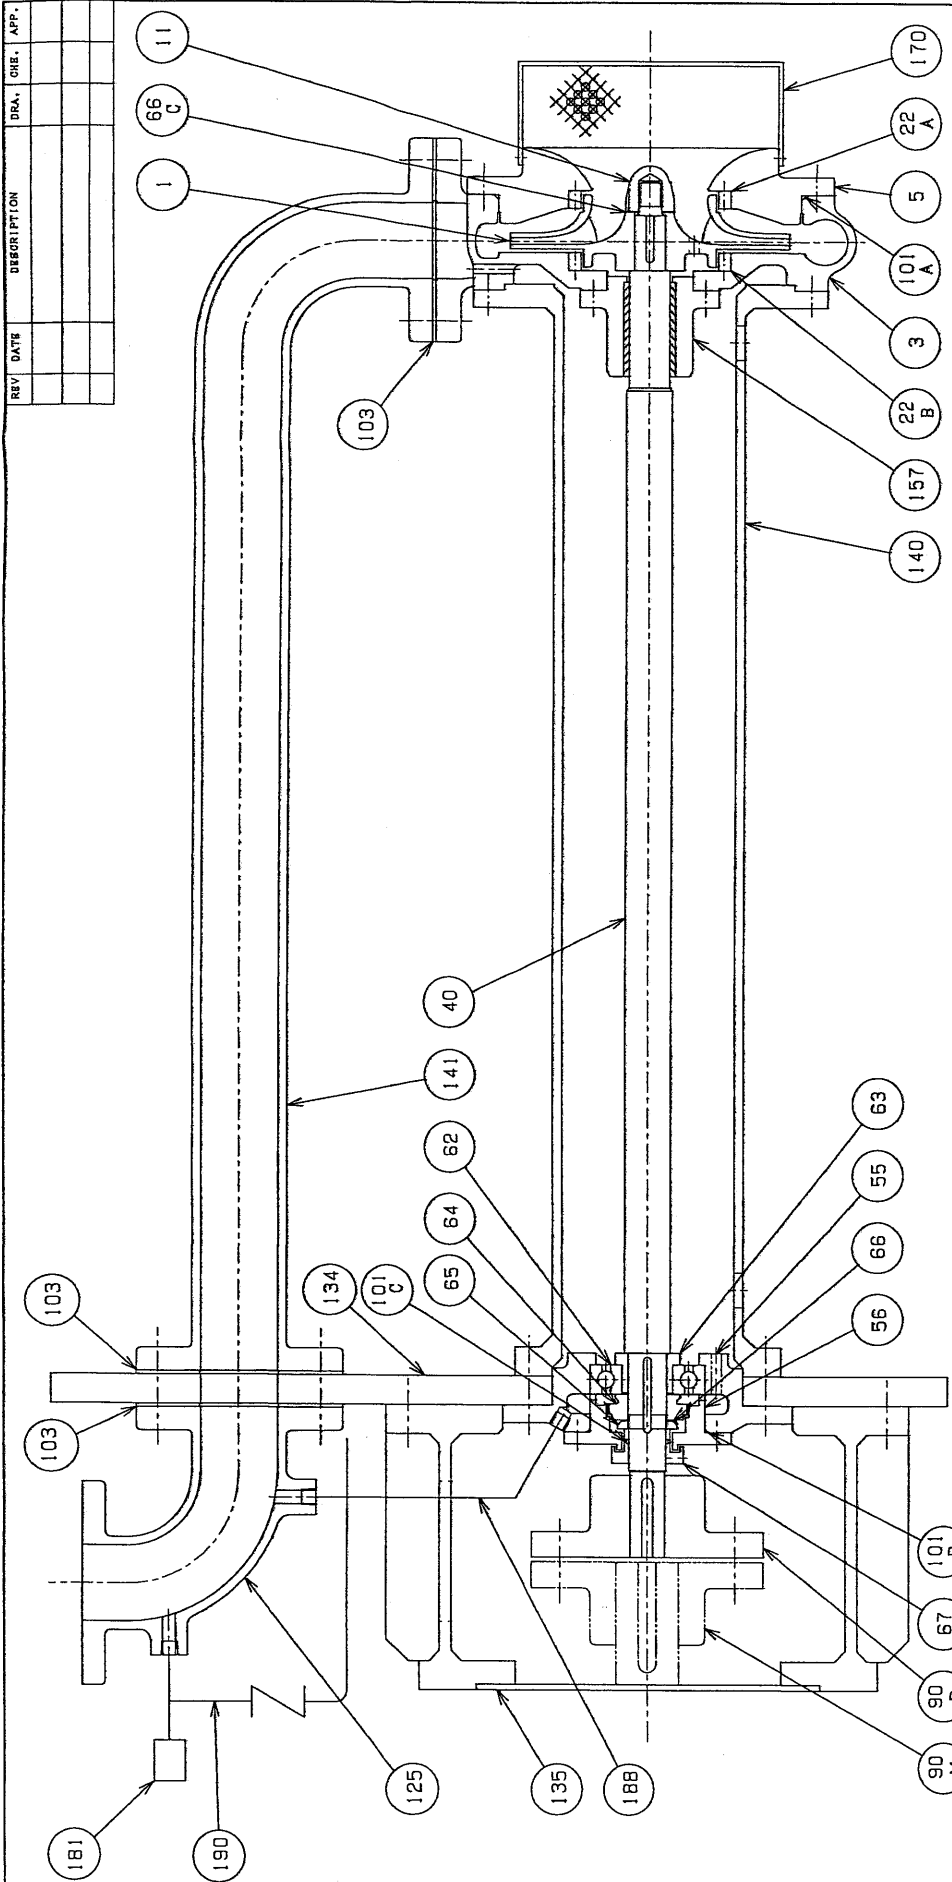


REV.	DATE	DESCRIPTION	DRW.	CHK.	APP.

品番	部品名	数量	材質	備考	品番	部品名	数量	材質	備考
63	BEARING BUSHING	1	S25C		103	SHEET PACKING	3	NONE	
62	BALL BEARING	1	#6309		101C	O-RING	1	NBR #832	
56	BEARING CASE COVER	1	FC200		101B	O-RING	1	NBR #8100	
55	BEARING CASE	1	FC200		101A	O-RING	1	NBR #260X3.2	
40	SHAFT	1	SUS304		90M	COUPLING HUB	1	FC200	
22B	CASING WEARING	1	SUS304		90P	COUPLING HUB	1	FC200	
22A	CASING WEARING	1	SUS304		67	DEFLECTOR	1	SUS304	
11	IMPELLER NUT	1	SUS304		66C	IMPELLER WASHER	1	SUS304	
5	SUCTION COVER	1	FC200		66	BEARING WASHER	1	SPCC JIS A407	
3	CASING	1	FC250		65	BEARING NUT	1	SS400 JIS A407	
1	IMPELLER	1	SS413		64	BEARING COLLAR	1	S25C	
11	IMPELLER	1	SS400H-STPG370		125	DISCHARGE BEND	1	S25C	
3	CASING	1	SS400		134	FLOOR BASE	1	SS400	
5	SUCTION COVER	1	FC200		135	MOTOR FRAME	1	SS400	
11	IMPELLER NUT	1	SUS304		140	COLUMN	1	SS400H-STPG370	
22A	CASING WEARING	1	SUS304		141	DISCHARGE PIPE	1	SS400H-STPG370	
22B	CASING WEARING	1	SUS304		157	BOTTOM CASING BEARING	1	FC200H-CARBON	
40	SHAFT	1	SUS304		170	STRAINER	1	SUS304	
55	BEARING CASE COVER	1	FC200		181	SOCKET (GAUGE CONNECTION)	1	S25C	SW1/2
56	BEARING CASE	1	FC200		180	AIRVENT PIPE	1	SUS304TH	
62	BALL BEARING	1	#6309		188	LUBRICATION PIPE	1	SUS304TH	
63	BEARING BUSHING	1	S25C		190	AIRVENT PIPE	1	SUS304TH	

ST7C5442B 5/10

SECTIONAL DRAWING	
SERVICER	EMERGENCY OIL PUMP
WORK No.	200712-2
APPROVED	天野
CHECKED	吉良
DRAWN	橋本
ITEM No.	P-203
MODEL	VSC
SCALE	NONE
DATE	JULY, 11, 2007
DWG No.	K3007379
KANSUI PUMP CO., LTD.	

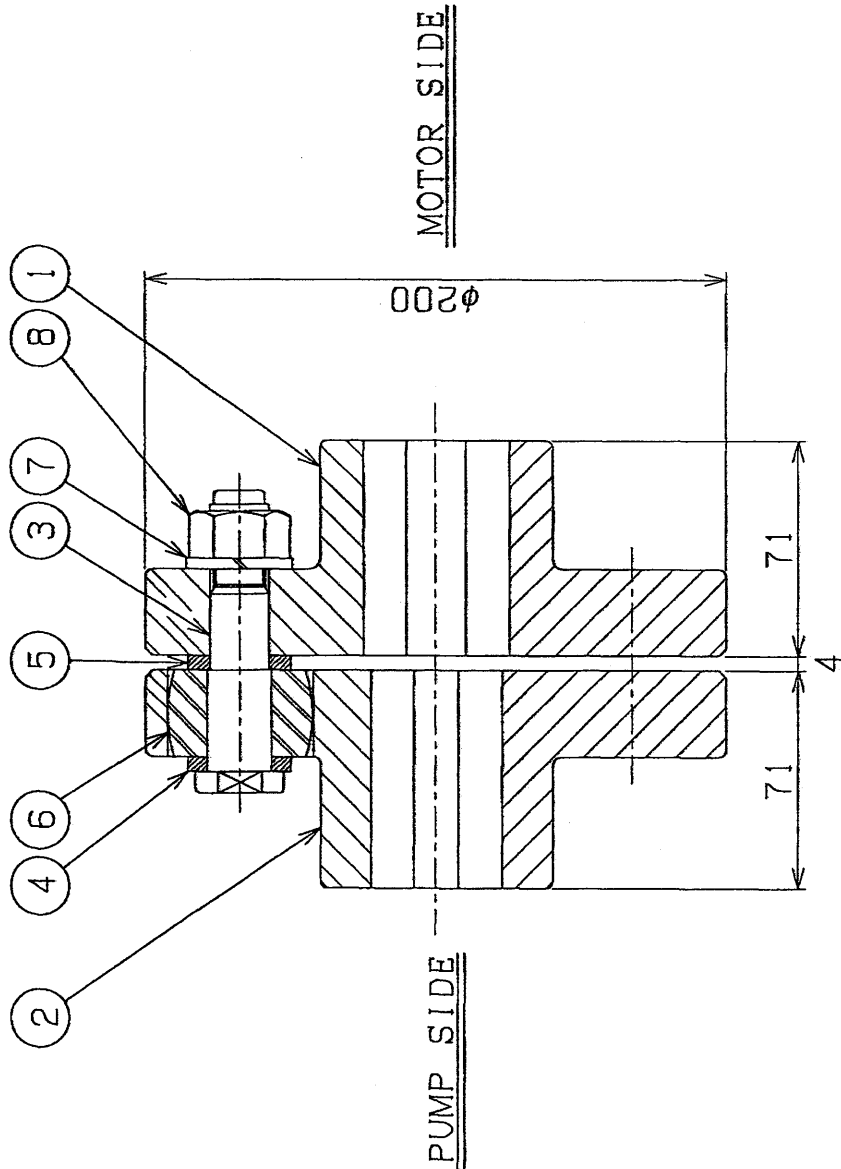

No.	部品名称	材質	数量
①	HUB	FC200	1
②	HUB	FC200	1
③	BOLT	SS400	8
④	WASHER	SS400	8
⑤	WASHER	SS400	8
⑥	BUSH	NBR	8
⑦	SPRING WASHER	SWRH62	8
⑧	NUT	SS400	8

JIS B1452 CL#200

COUPLING

SERVICE	EMERGENCY OIL PUMP	
WORK No.	200712-2	ITEM No. P-203
APPROVED	天野	MODEL VSC
CHECKED	右良	SCALE NONE
DRAWN	橋本	DATE Oct.29.2007
DWG NO.	H4007101	



KANSUI PUMP CO., LTD.

REV	DATE	DESCRIPTION	DRA.	CHE.	APP.

F No H D 図 番 H4007093

REV 改訂	DATE 日付	DESCRIPTION 記 述	DRA 作成	CHE 審査	APP 承認
△					
△					
"ETCHING" LETTER

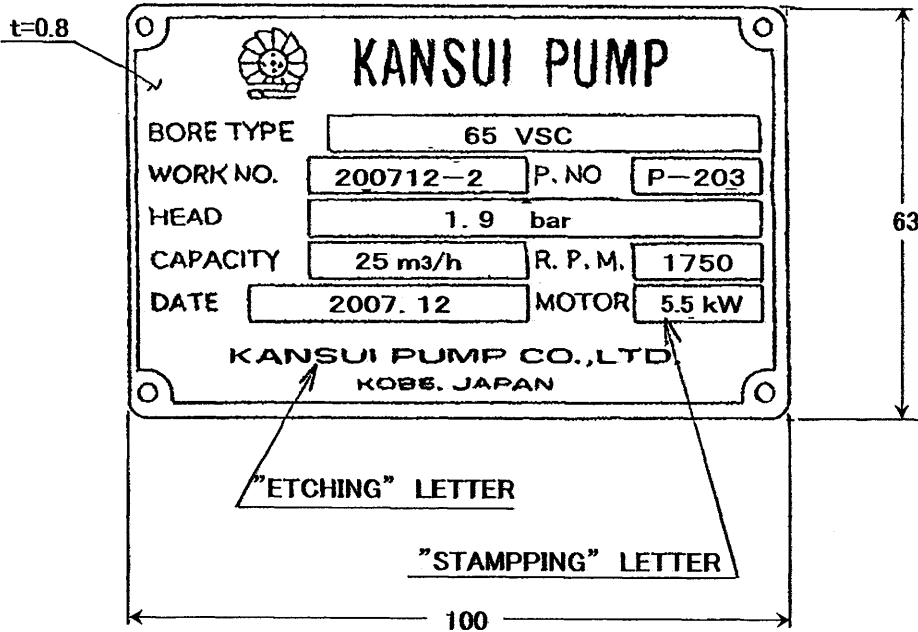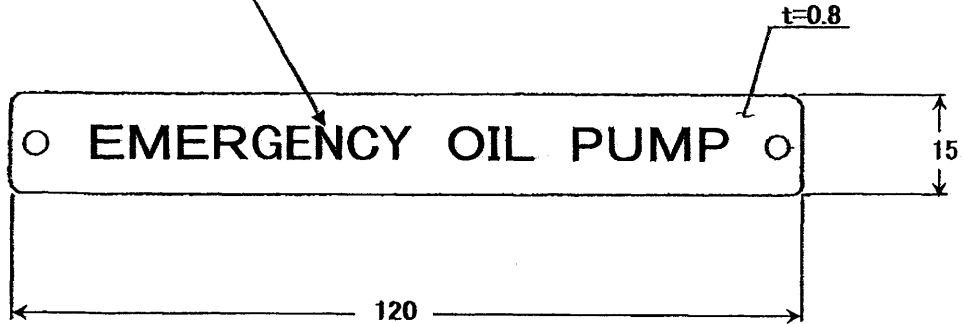

MATERIAL : SUS304

WORK No	200712-2	
APP 天野	CUSTOMER FUJI ELECTRIC SYSTEMS CO.,LTD	
CHE 古良	USER	WAYANG WINDU
DRA 橋本	SERVICE	EMERGENCY OIL PUMP
	NAME	NAME PLATE
DATE Oct. 3. 2007	DWG No H4007093	REV △ 0
KANSUI PUMP CO.,LTD		



ST7C5442B 7/10

ACCESSORIES LIST

EQUIP NO		P-203		TYPE-MODEL NO		65 VSC-1 #2640	
SERVICE		EMERGENCY OIL PUMP		NO REQUIRED		1	
NO	PART NAME	MATERIAL	NOREQ'D 員数		REMARKS		
				Total			
1	Emergency Oil pump			1			
2	Motor			1	Articles supplied		
3	Flexible coupling	FC200		1Set	Installed		
4	Bolt, Nut, Washer, Bush			8Sets	For Coupling		
5	Floor base	SS400		1	Installed		
6	Air vent pipe	SUS304		1Set	Installed		
7	Lubrication pipe	SUS304		1Set	Installed		
8	Coupling cover	SS400		2Sets	Installed		
9	Strainer	SUS304		1Set	Installed		
△ 10	Eye bolt	SS400		4	Installed		
11							
12							
13							
					APP.	矢野	
					CHEK.	吉良	
					MADE	橋本	
1	Oct 29 2007	Eye bolts are added	橋本	吉良	DATE	Oct 3 2007	
REV	DATE	DESCRIPTION	MADE	CHE	APP	WORK NO	200712-2



DWG NO P0312964

Dimensions in mm

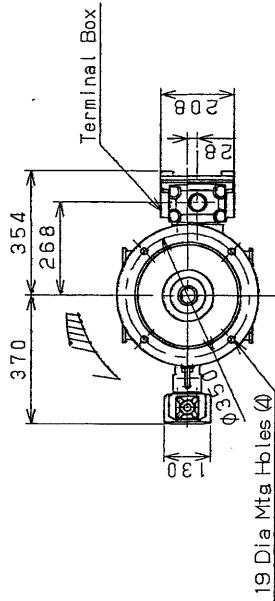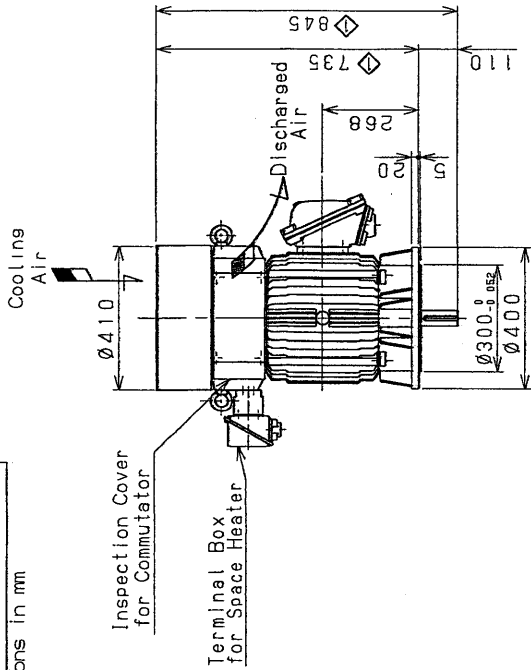

19 Dia Mtg Holes (4)

Detail of Terminal Box

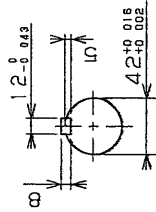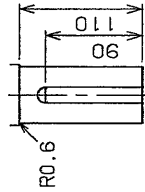

Detail of Shaft Extension

Notes:

- Standards : NEMA MG-1, Thermal classification : F/Brise
- Rotation direction (Facing drive end) : Clockwise Counter clockwise Reversible
- Thermostat : Request With Without
- Drive method : Direct drive
- Shaft extension key is furnished by Yaskawa
- Regreasable type bearings packed with lithium based grease are used
- Enclosure : IP55
- Space Heater Output_50 W, Phase_1, Voltage_220V
- Noise : 82dB (A) Full Load

YASKAWA PRESENTATION STAMP
 Sep.12.2007.
 YASKAWA ELECTRIC CORPORATION

Approx. Inertia (GD²/4)	Bearing No.
Mass kg	End opp. Drive
245	0 35 6311ZZ 6310ZZ

Customer -----
 End User -----
 Application -----
 Order No. - Item No T760082-1
 Estimate No -----

RATINGS







Type	Output kW	Time Rating	Speed min-1	Voltage V	Excitation	Frame No.
GFEVF	5.5	CONT	1750	230	SELF WITH STABI	GFEV-180L

TITLE	Dimensions of DC Motor		DWG. NO	P0312964
Totally Enclosed Fan-Cooled Type				
作 成 DRAW	S. Honda	REV	◇	
檢 査 CHECK	K Oyama	DATE	Sep 10 07S Kondok Oyama	
承 認 APPR		BY	SCALE	

DWG NO. P0313400

Order No T76062-1

YASKAWA
 PRESENTATION
 STAMP
 Sep. 25, 2007.
 YASKAWA ELECTRIC CORPORATION

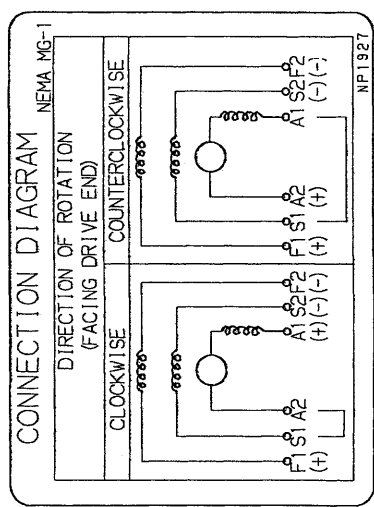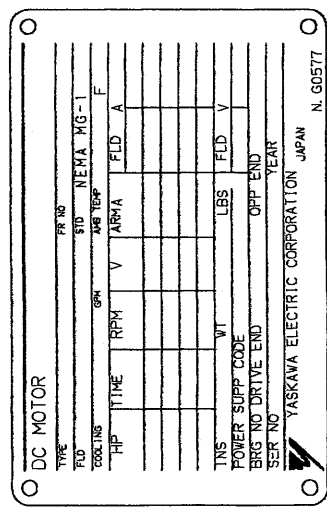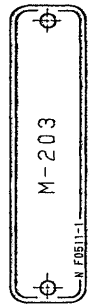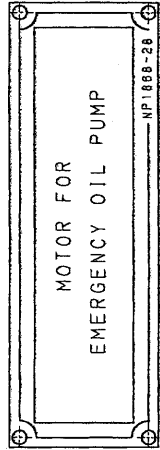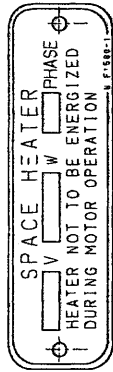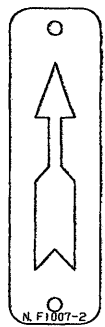

⚠ DANGER

ROTATING EQUIPMENT INSIDE
 COVER MUST BE CLOSED
 PRIOR TO OPERATING EQUIPMENT

N.F.6636

REV	◇
DWG. NO	P0313400
TITLE	Name Plate
作 製	S. Honda
DR 脚	
CHECK 査	K Oyama
APPR 承認	
DESCRIPTION	DATE
BY	APPR
SCALE	