Downloaded on 27 September 2024 11:39 | Tri Okta Ervina - ENG BJS

5. Condenser Section Drawing

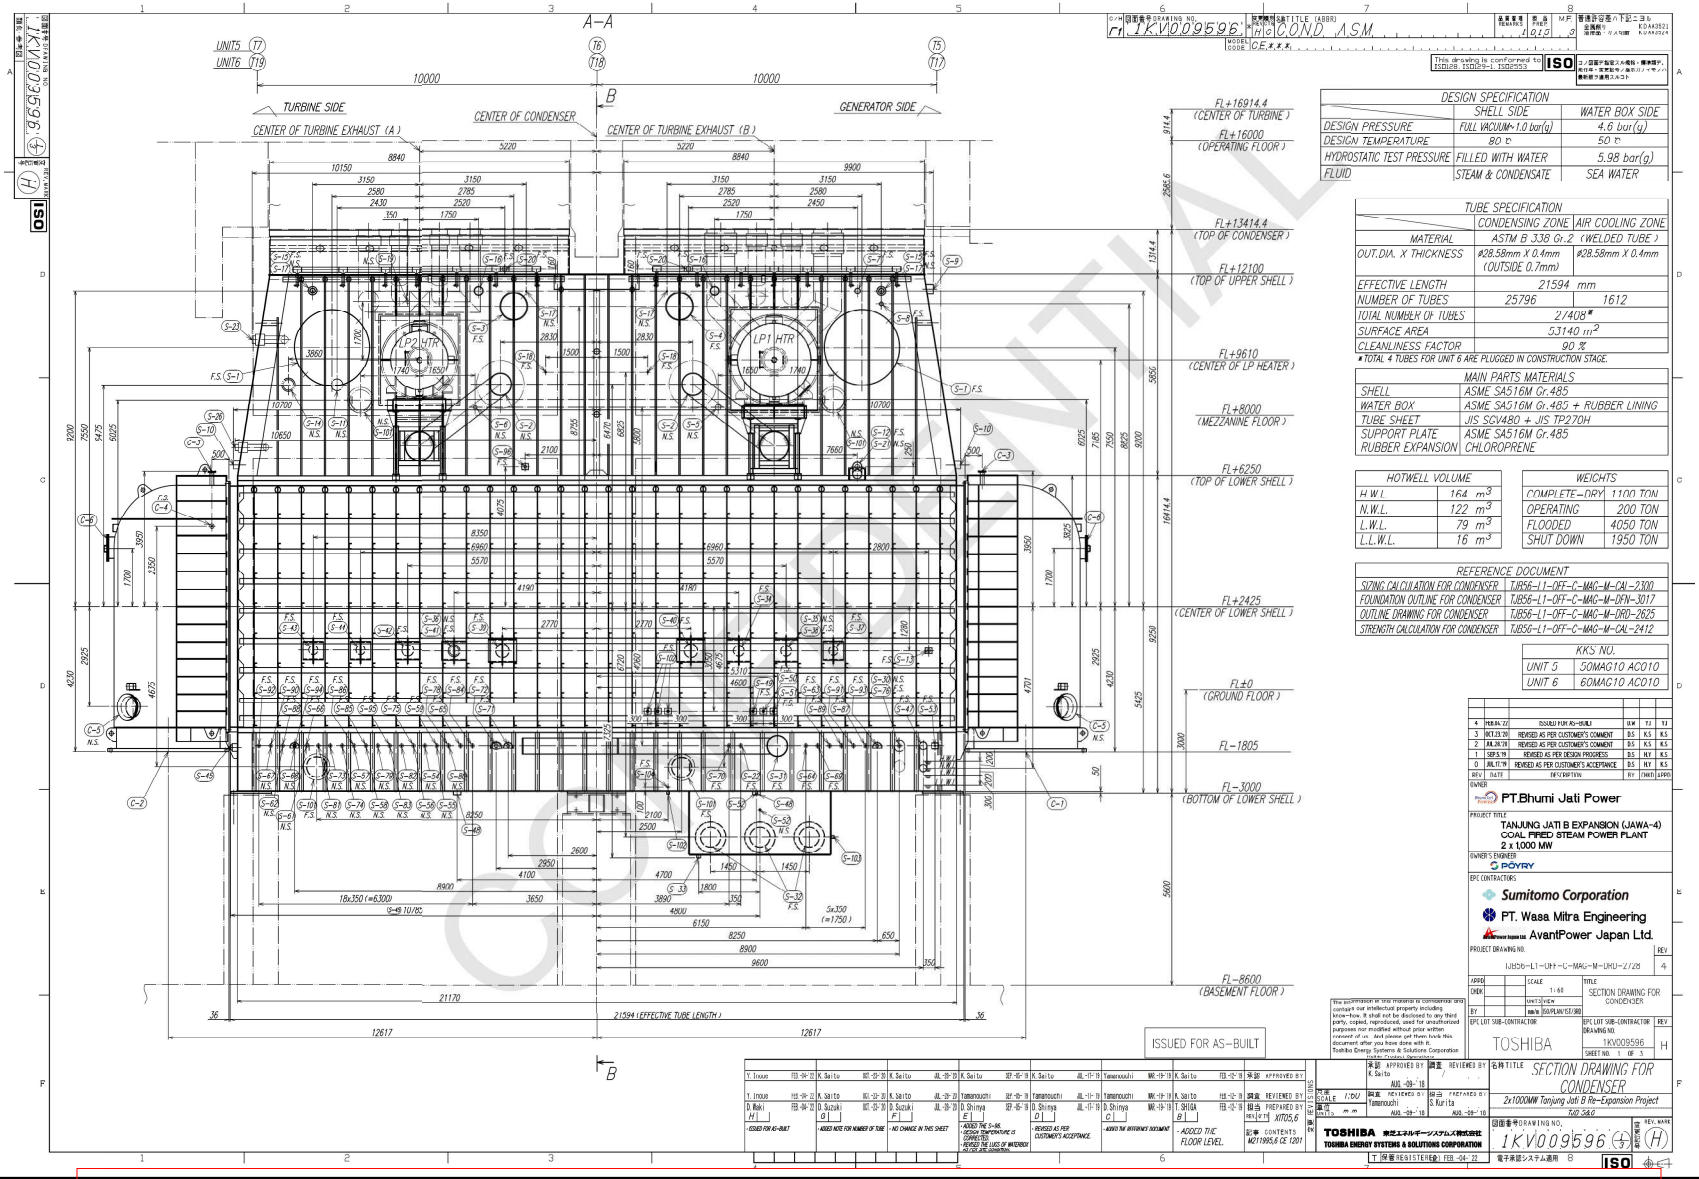

DESIGN SPECIFICATION	SHELL SIDE	WATER BOX SIDE
DESIGN PRESSURE	FULL VACUUM×1.0 bar(g)	4.6 bar(g)
DESIGN TEMPERATURE	80 ℃	50 ℃
HYDROSTATIC TEST PRESSURE	FILLED WITH WATER	5.98 bar(g)
FLUID	STEAM & CONDENSATE	SEA WATER

TUBE SPECIFICATION	CONDENSING ZONE	AIR COOLING ZONE
MATERIAL	ASTM B 338 Gr.2 (WELDED TUBE)	
OUT.DIA. X THICKNESS	ø28.58mm X 0.4mm (OUTSIDE 0.7mm)	ø28.58mm X 0.4mm
EFFECTIVE LENGTH	21594 mm	
NUMBER OF TUBES	25796	1612
TOTAL NUMBER OF TUBES	27408*	
SURFACE AREA	53140 m²	
CLEANLINESS FACTOR	90 %	

* TOTAL 4 TUBES FOR UNIT 6 ARE PLUGGED IN CONSTRUCTION STAGE.

MAIN PARTS MATERIALS	
SHELL	ASME SA516M Gr.485
WATER BOX	ASME SA516M Gr.485 + RUBBER LINING
TUBE SHEET	JIS SCV480 + JIS TP270H
SUPPORT PLATE RUBBER EXPANSION	ASME SA516M Gr.485 CHLOROPRENE

HOTWELL VOLUME	
H.W.L.	164 m³
N.W.L.	122 m³
L.W.L.	79 m³
L.L.W.L.	16 m³

WEIGHTS	
COMPLETE-DRY	1100 TON
OPERATING	200 TON
FLOODED	4050 TON
SHUT DOWN	1950 TON

REFERENCE DOCUMENT	
SIZING CALCULATION FOR CONDENSER	TJB56-L1-OFF-C-MAG-M-CAL-2300
FOUNDATION OUTLINE FOR CONDENSER	TJB56-L1-OFF-C-MAG-M-DRN-3017
OUTLINE DRAWING FOR CONDENSER	TJB56-L1-OFF-C-MAG-M-ORD-2625
STRENGTH CALCULATION FOR CONDENSER	TJB56-L1-OFF-C-MAG-M-CAL-2412

KKS NO.	
UNIT 5	50MAG10 AC010
UNIT 6	60MAG10 AC010

REV	DATE	DESCRIPTION	BY	CHKD	APPD

OWNER: PT.Bhumi Jati Power
PROJECT TITLE: TANJUNG JATI B EXPANSION (JAWA-4) COAL FIRED STEAM POWER PLANT 2 x 1,000 MW
OWNER'S ENGINEER: POYRY
EPC CONTRACTORS: Sumitomo Corporation / PT. Wasa Mitra Engineering / AvantPower Japan Ltd.
SCALE: 1:60
TITLE: SECTION DRAWING FOR CONDENSER
EPC LOT SUB-CONTRACTOR: TOSHIBA
EPC LOT SUB-CONTRACTOR DRAWING NO.: 1KV009596 REV H
SHEET NO.: 1 OF 3

承認 APPROVED BY	調査 REVIEWED BY	作成 PREPARED BY
K.Saito AUG.-09-'18	Tamanouchi AUG.-09-'18	S.Kurita AUG.-09-'18

SCALE 1:60
TOSHIBA 東芝エネルギーシステムズ株式会社 TOSHIBA ENERGY SYSTEMS & SOLUTIONS CORPORATION
T 保留 REGISTERED FEB.-04.'22
名称 TITLE: SECTION DRAWING FOR CONDENSER
2x1000MW Tanjung Jati B Re-Expansion Project
TJB 5&6
図面番号 DRAWING NO.: 1KV009596 (H) REV. MARK
電子承認システム適用 ISO

CONFIDENTIAL

Uncontrolled when printed or downloaded. Verify that this is the correct version before use.
Reproduction of part or all the contents of the document is prohibited without written permission from PT. Bhumi Jepara Service